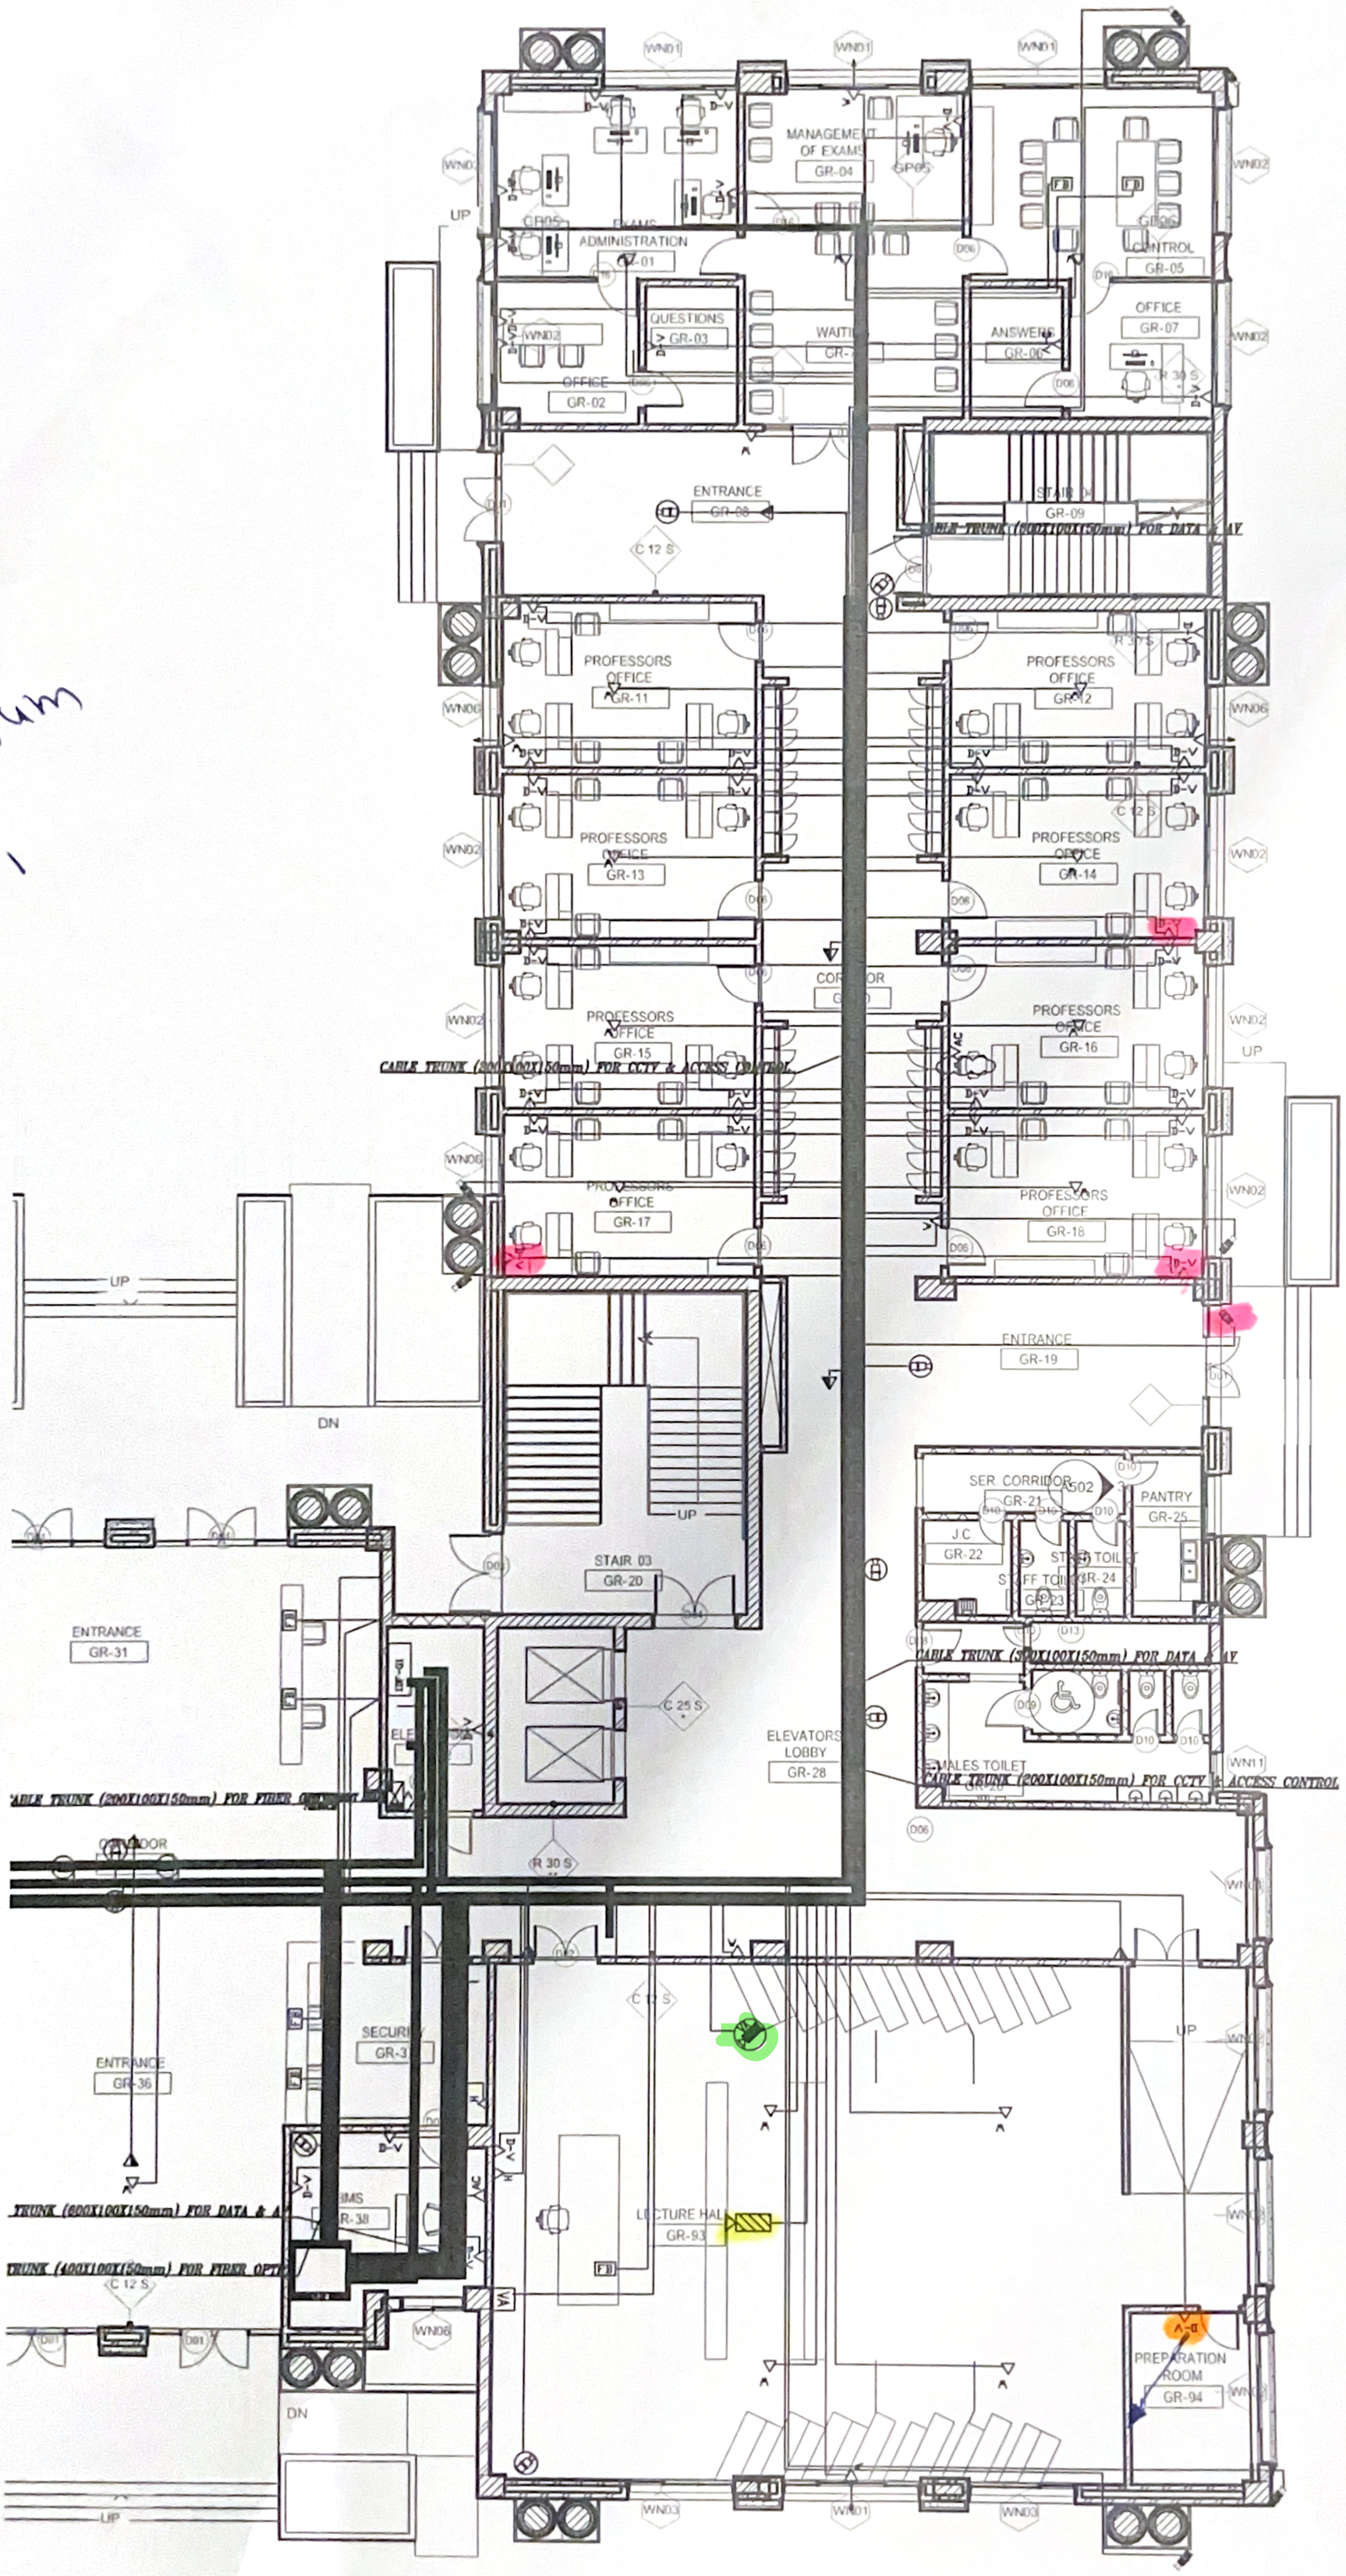

ADMINISTRATION
GR-01
QUESTIONS
GR-03
OFFICE
GR-02
MANAGEMENT OF EXAMS
GR-04
ANSWERS
GR-06
CONTROL
GR-05
OFFICE
GR-07
ENTRANCE
GR-08
STAIR 04
GR-09
PROFESSORS OFFICE
GR-11
PROFESSORS OFFICE
GR-12
PROFESSORS OFFICE
GR-13
PROFESSORS OFFICE
GR-14
PROFESSORS OFFICE
GR-15
PROFESSORS OFFICE
GR-16
PROFESSORS OFFICE
GR-17
PROFESSORS OFFICE
GR-18
ENTRANCE
GR-19
SER. CORRIDOR
GR-21
PANTRY
GR-25
J.C
GR-22
STAFF TOILET
GR-24
STAFF TOILET
GR-23
MALES TOILET
GR-26
STAIR 03
GR-20
ENTRANCE
GR-31
ELEVATORS LOBBY
GR-28
ENTRANCE
GR-36
LECTURE HALL
GR-93
PREPARATION ROOM
GR-94
UP
DN
CABLE TRUNK (200X100X150mm) FOR DATA & AV
CABLE TRUNK (200X100X150mm) FOR CCTV & ACCESS CONTROL
TRUNK (600X100X150mm) FOR DATA &
TRUNK (400X100X150mm) FOR FIBER OPTIC